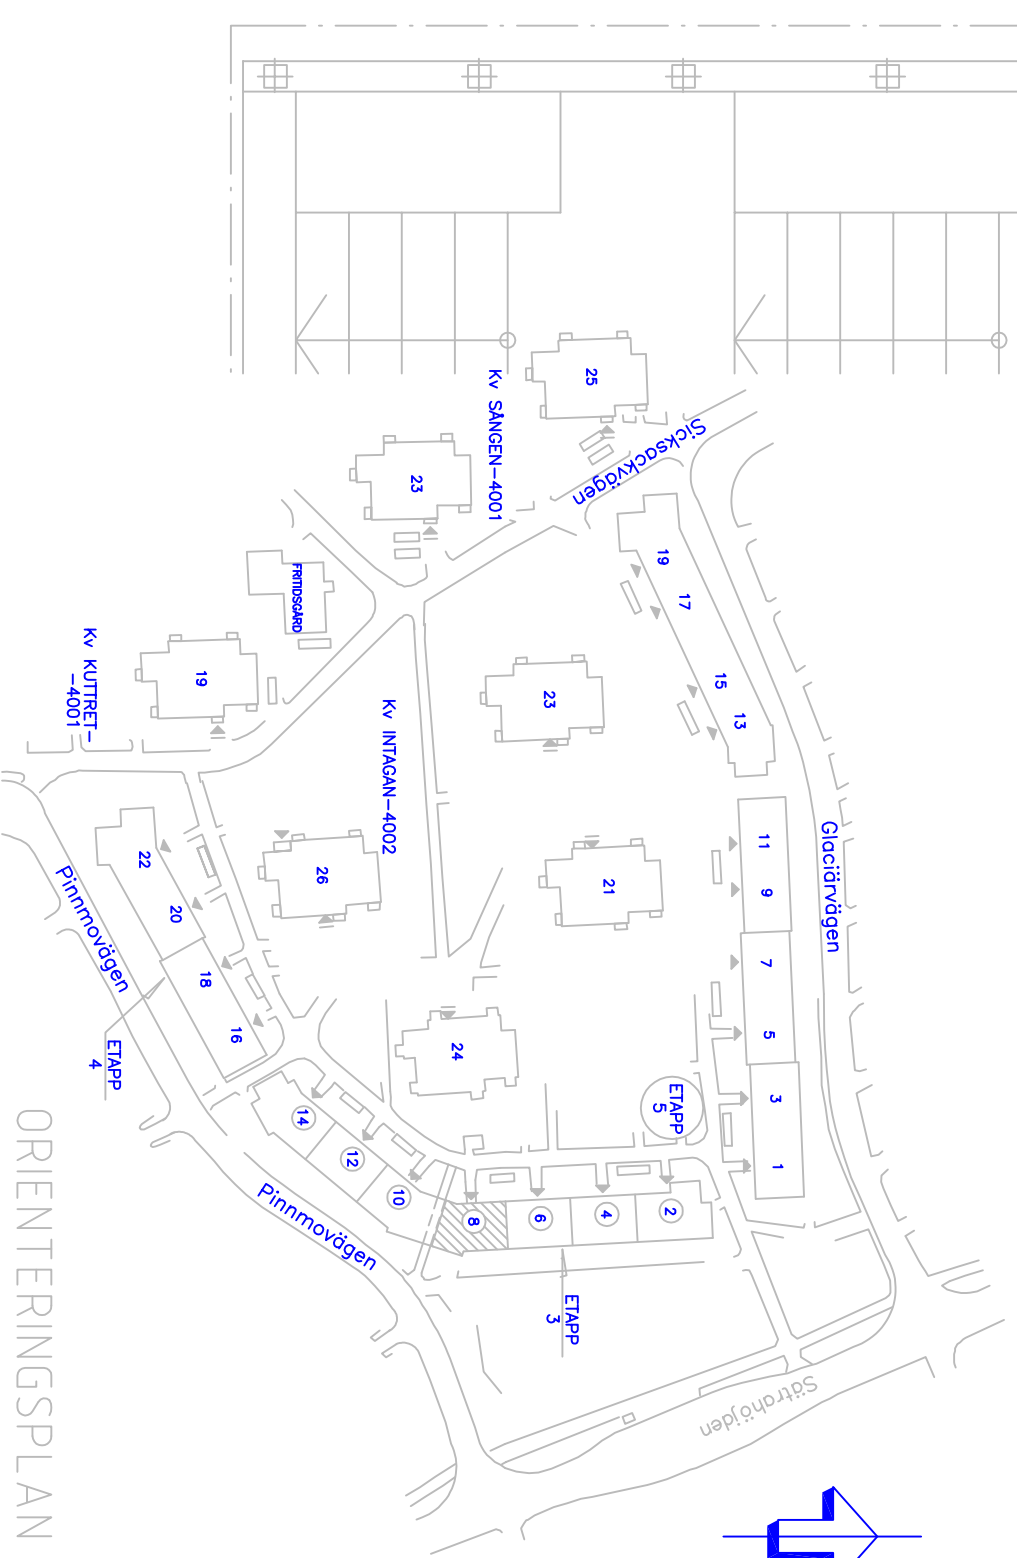


RELATIONSHANDLING
2003-12-15

Gavlegårdarna

801 06 GÄVLE
Tel. 026-172700

 N. SKEPPSBRON / 803 10 GAVLE
Tel 026-61 20 19
Fax 026-65 36 20

KEA Ingeniørbyrå AB	TEL: 026 - 53
N. Skeppshorn 7, 803 10 GÖVLE	FAX: 026 - 51

DATUM	ANSVARIG
2002-06-25	M. HEMSTRÖM

KÄLLARPLAN, ENTRÉ &

1:20/A1	E61-3-014
1:100/A3	