



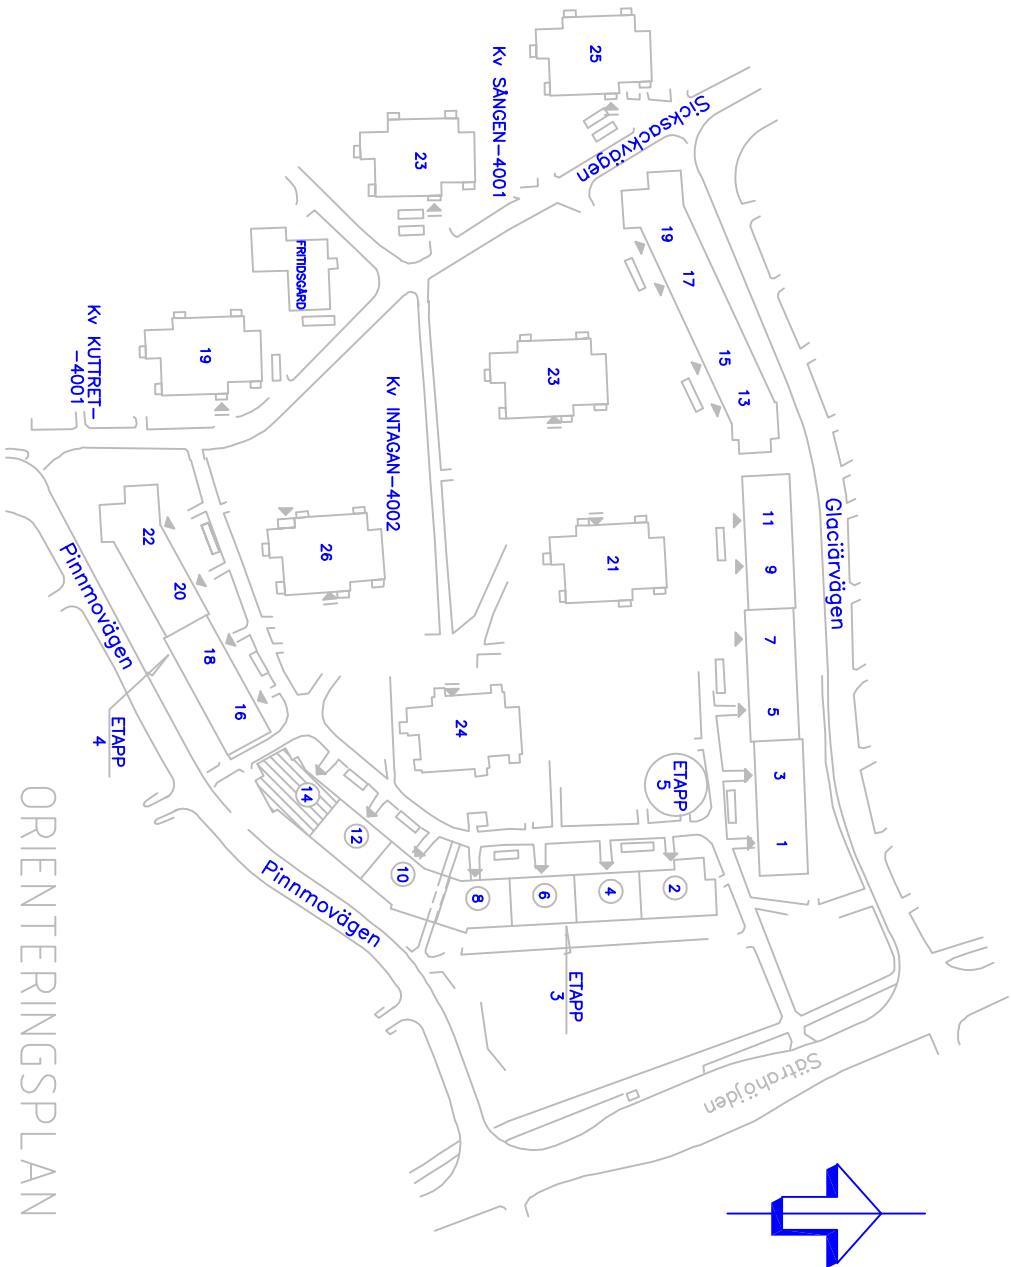

REV	ANT	ÄNDRINGEN ANSÖR	SOBJ	DATUM
-----	-----	-----------------	------	-------

RELATIONSHANDLING
2003-12-15

PROJEKT 4.002-24.009
STUDENTLÄGENHETER
Kv. INTÄGAN ETAPP 3, GÄVLE

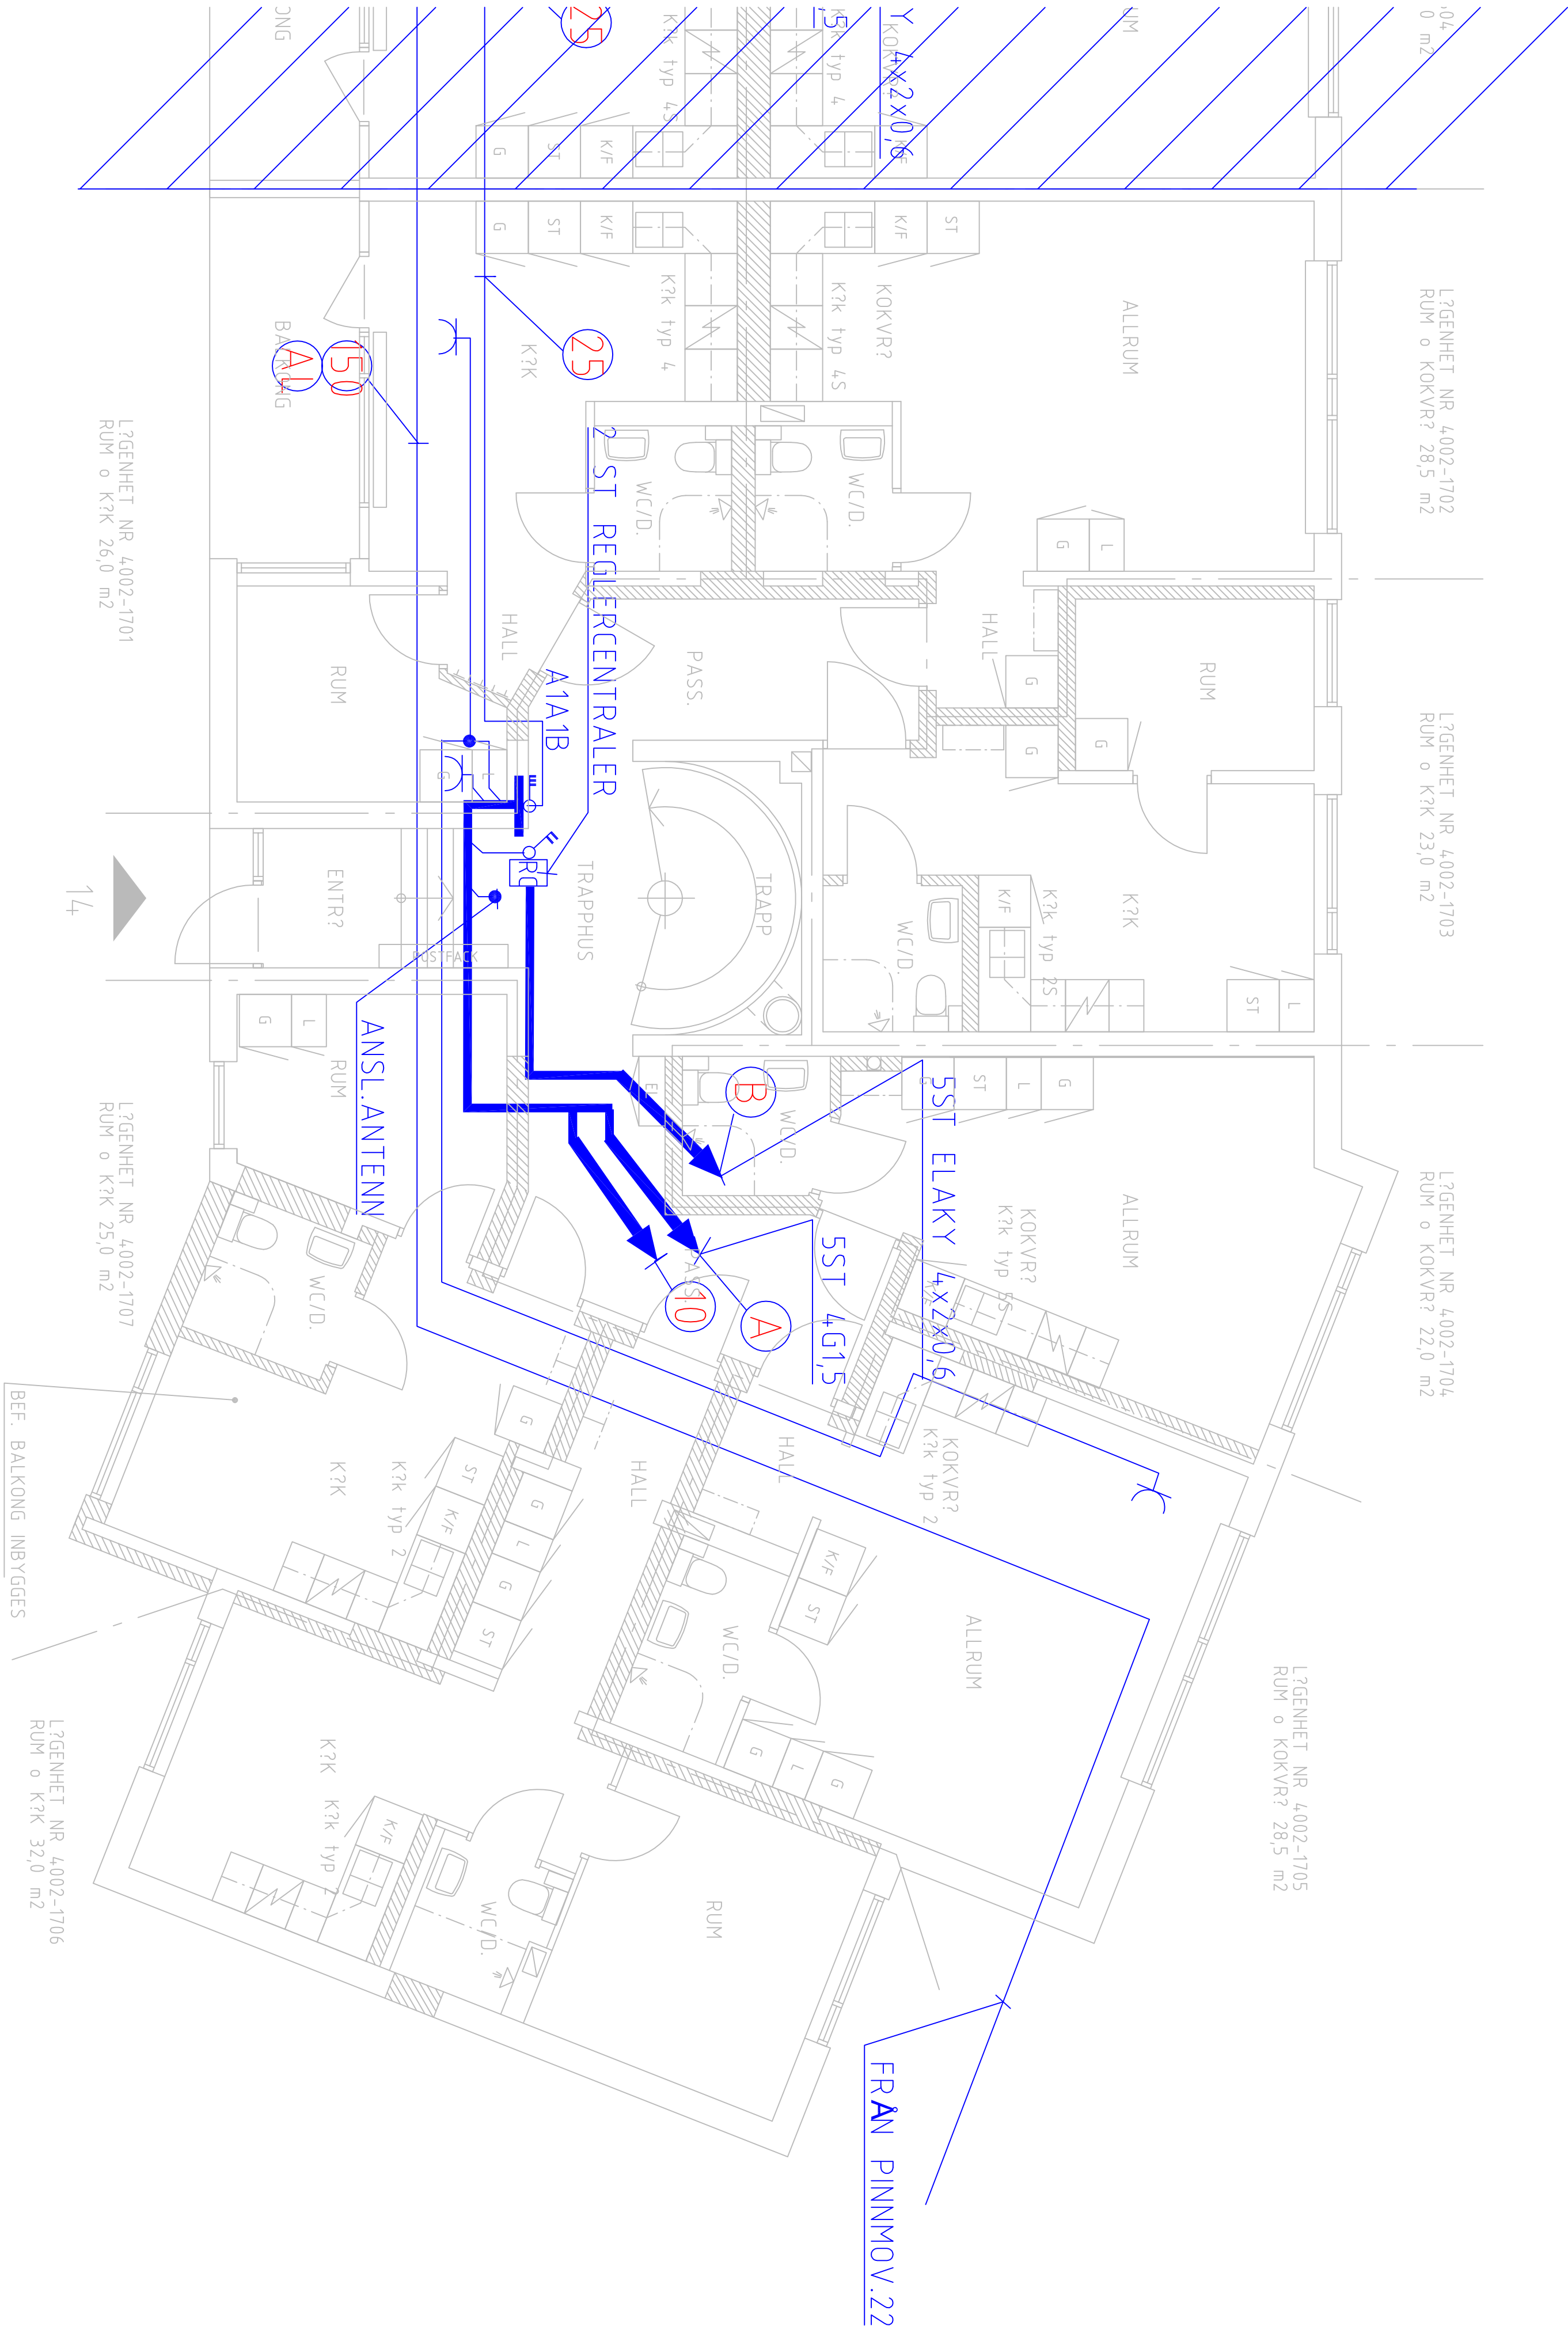

Gavlegårdarna
S. Kungälvägen 25
Box 456
801 08 GÄVLE
Tel. 026-172100 Fax. 026-172107



Gävle Elprojekttering AB
N. Skerfvarn 7
803 10 GÄVLE
Tel. 026-61 20 19
Fax. 026-61 20 20

TEL. 026 - 10 23 32	TEL. 026 - 10 23 32
FAX. 026 - 10 23 32	FAX. 026 - 10 23 32
TEL. 026 - 10 23 32	TEL. 026 - 10 23 32
FAX. 026 - 10 23 32	FAX. 026 - 10 23 32

UPPDRAG NR	RIKSDOKUMENT NR	ANMÄRKNING	INOMRÅDET
02-010	NB	NB/MH	

2002-06-25
SAIRA 58.4, Pinnmovägen 2-14
OMBYGGNAD BEF. FLERBOSTADSHUS TILL
STUDENTLÄGENHETER
KÄLLARPLAN, ENTRÉ 14

SKALA	1:50/A1	NUMMER	BET
1:100/A3	E61-3-017		A