


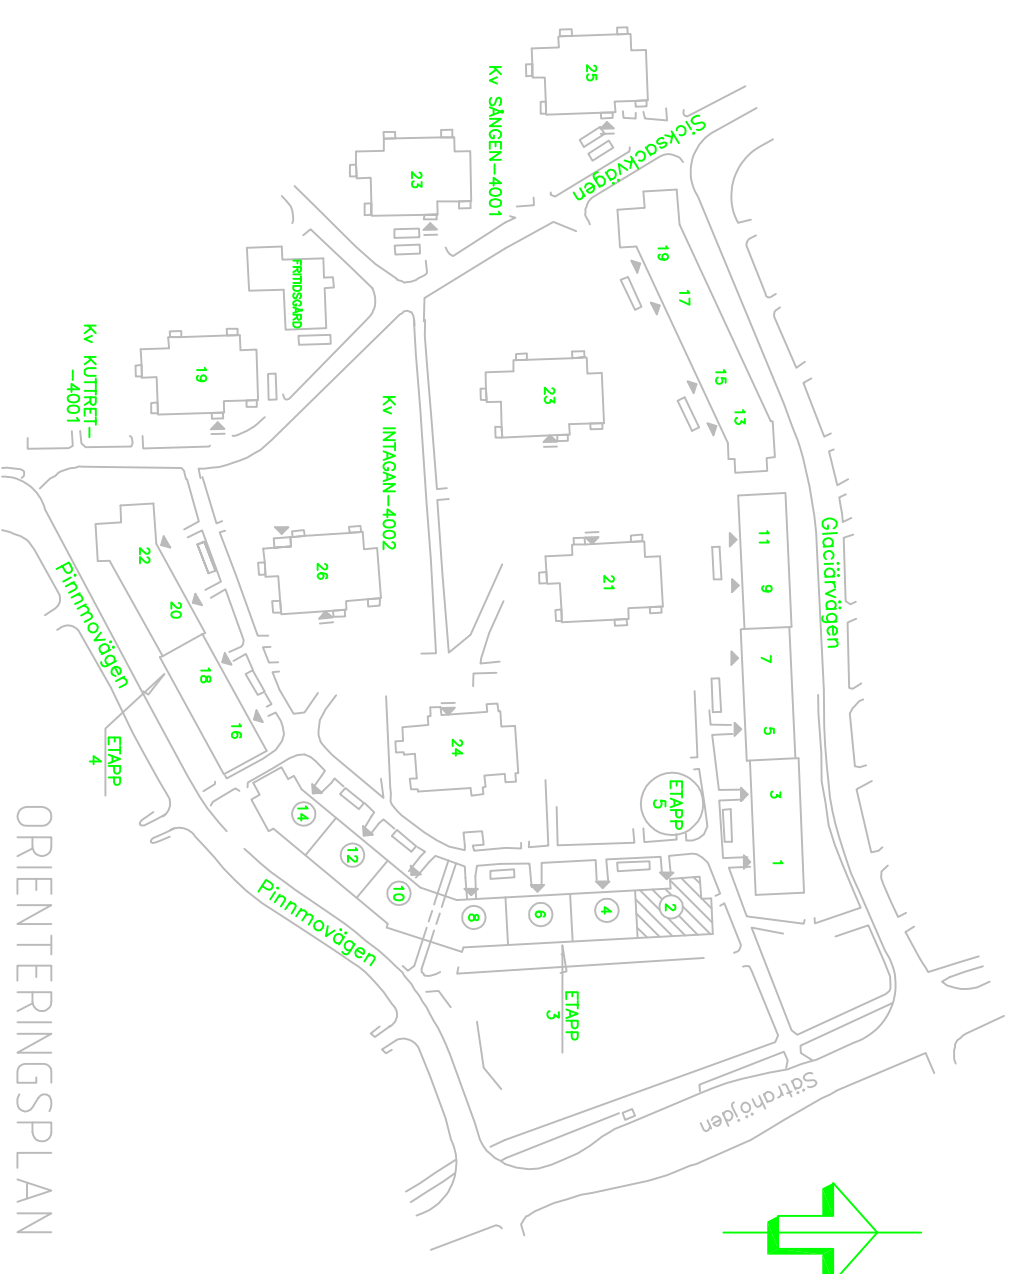

RELATIONSHANDLING
2003-12-15

Gavlegårdarna
S. Kungsvägen 25
Box 456
801 06 GÄVLE
Tel. 026-172700 Fax. 026-172707

A	CW Depositional AB	TEL: 026 - 51
	SW Depositional 206, 805 92 GYVLE	FAX: 026 - 50
K	CW Depositional AB	TEL: 026 - 51
	SW Depositional 206, 805 92 GYVLE	FAX: 026 - 50
E	CW Depositional AB	TEL: 026 - 51
	SW Depositional 7, 805 10 GYVLE	FAX: 026 - 65
V	KCA Ingenti 7abyo AB	TEL: 026 - 53
	SW Depositional 7, 805 10 GYVLE	FAX: 026 - 51

SÅTRA 58:4, Pimmovägen 2-14
OMBYGGNAD BEF. FLERBOSTADSHUS TILL
STUDENTLÄGENHETER
KÄLLARPLAN, ENTRÉ 2

TELE, KANALISATION		
SKALA	NUMBER	BET
1:50/A1		
1:100/A3	E64-3-011	A