
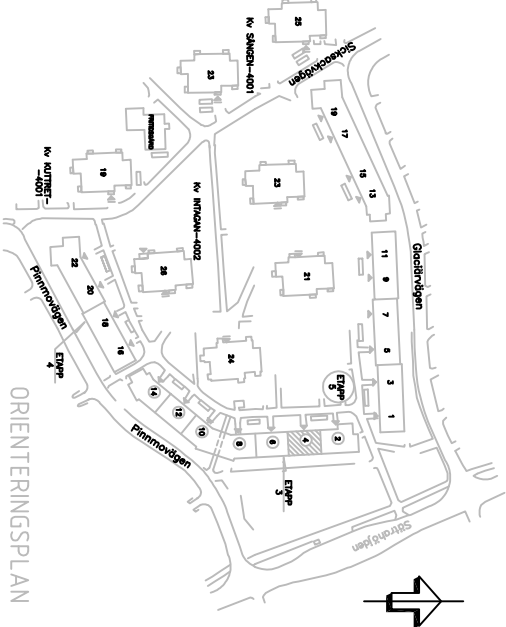


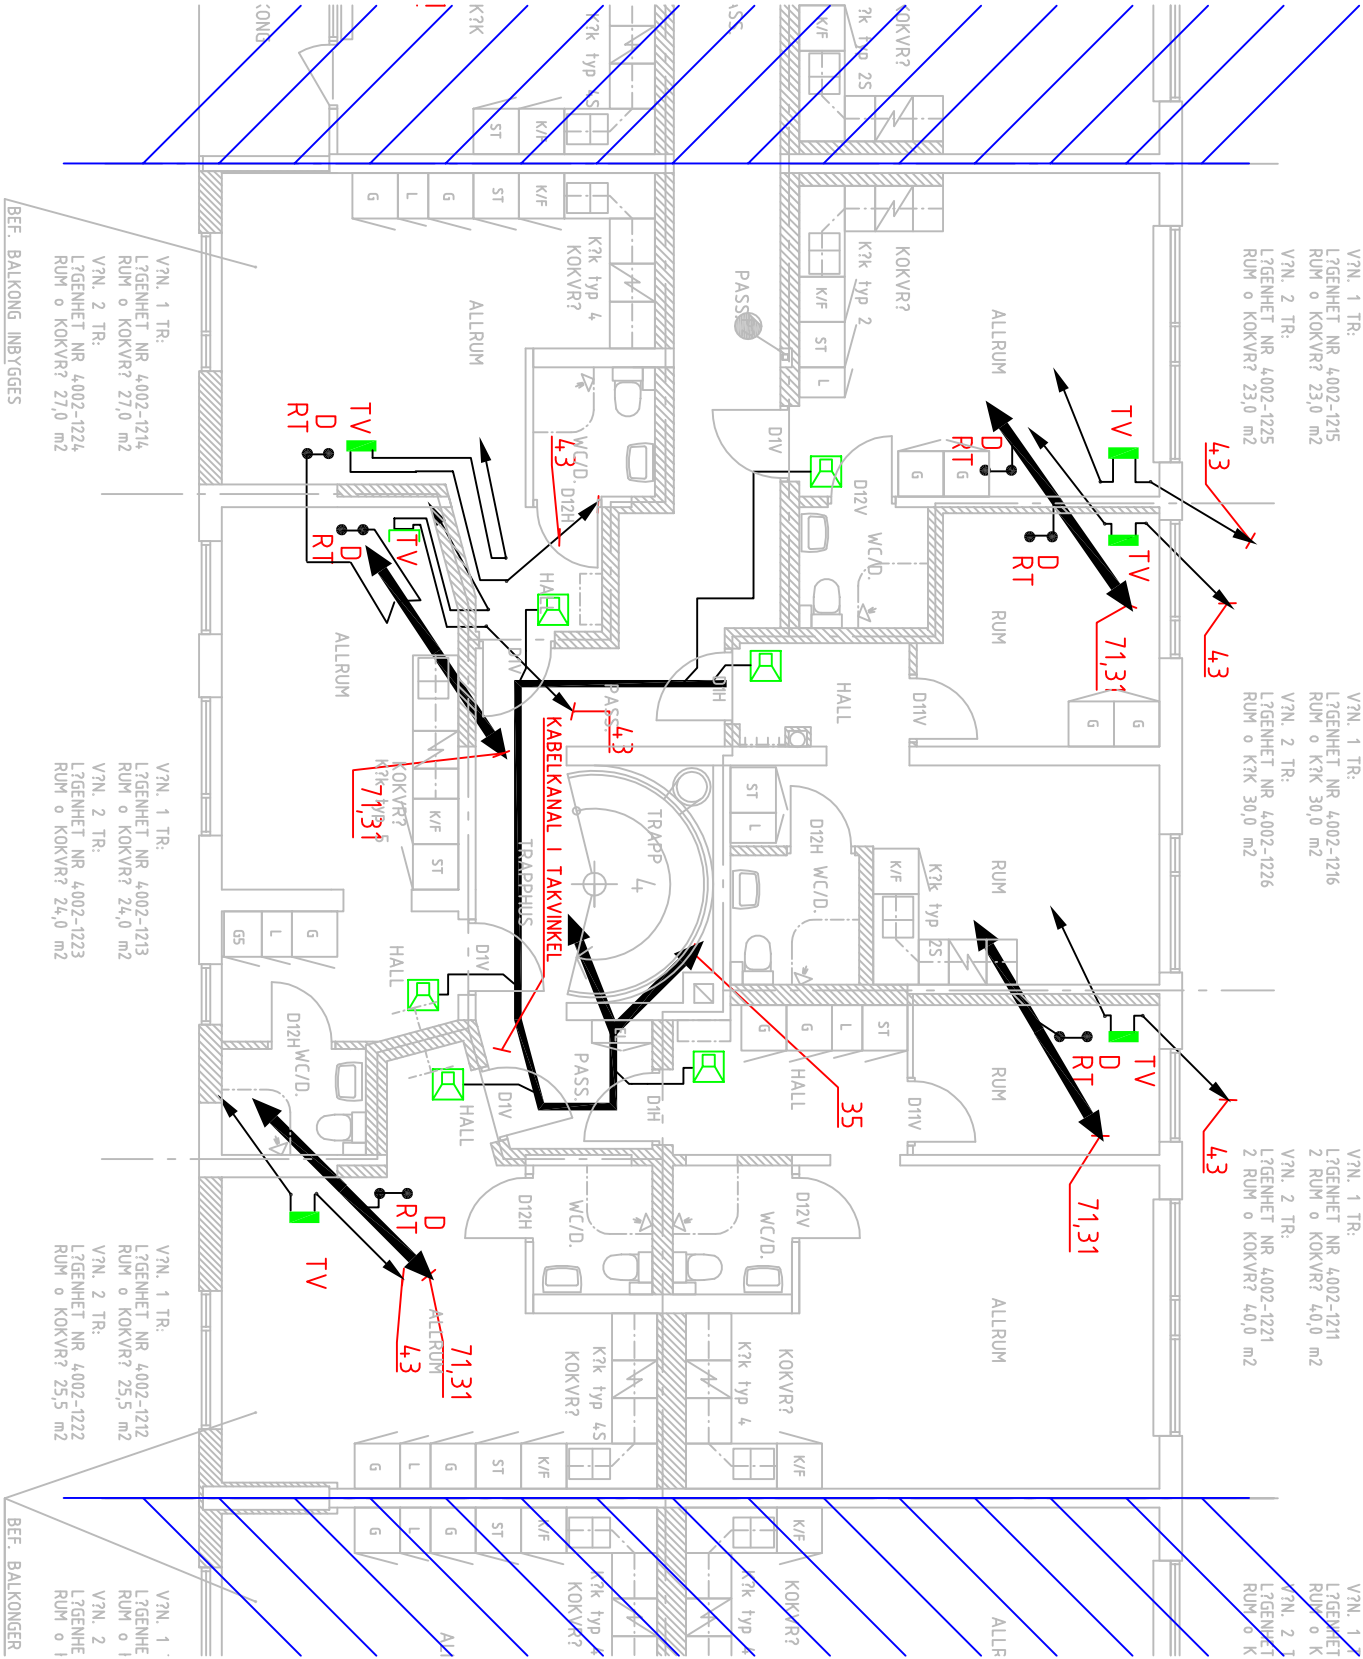

REV	ART	ÄNDRINGEN	N.B.	2002-10-04
		ÄNDRINGEN		

RELATIONSHANDLING	2003-12-15
-------------------	------------

PROJEKT	4.002-24.009
STUDENTLÄGENHETER	
KV. INTÄGNET ETAPP 3, GÄVLE	

	Gävle
S. Kungälvsgatan 25	
Box 456 GÄVLE	
0202-172700	Fax: 0206-172707

	GÄVLE
ELPROJEKTERING AB	
H. SKERFVINGEN 7	803 10 GÄVLE
Fax: 0206-61 20 18	
Fax: 0206-61 20 18	

A	ÖF. Byggnadsplan, 1:500, 1:200, 1:100, 1:50, 1:20	1:500, 1:200, 1:100, 1:50, 1:20
K	ÖF. Byggnadsplan, 1:50, 1:20, 1:100, 1:50, 1:20	1:500, 1:200, 1:100, 1:50, 1:20
E	ÖF. Byggnadsplan, 1:50, 1:20, 1:100, 1:50, 1:20	1:500, 1:200, 1:100, 1:50, 1:20
V	ÖF. Byggnadsplan, 1:50, 1:20, 1:100, 1:50, 1:20	1:500, 1:200, 1:100, 1:50, 1:20

ÖPPNINGS NR	RTITELNOMST. AV	INOMSTIGARE
02-010	NB	NB/MH
DATUM	ANVÄNDNING	
2002-06-25	M. HENSTRÖM	

SÄTRA 58:4, Pinnmovägen 2-14	
ÖMBYGGNAD BEF. FLERBOSTADSHUS TILL	
STUDENTLÄGENHETER	
VÄNNISPLAN 1-2, ENTRÉ 4	
TELE. KANALISATION	

SKALA	1:50/A1	NUMMER	E64-3-032	BET	A
	1:100/A3				